

RED LINED VERSION

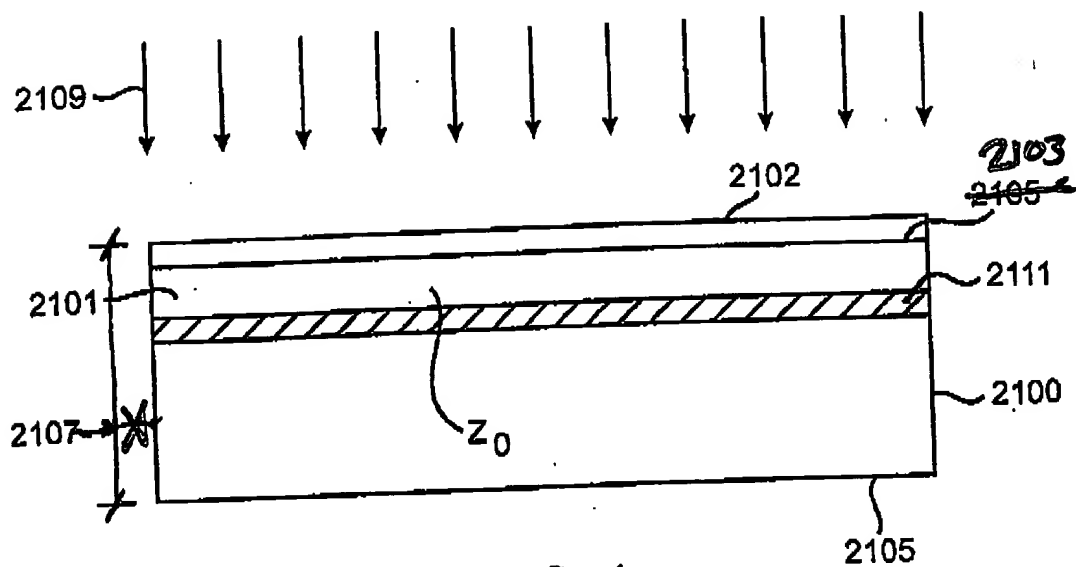


FIG. 1

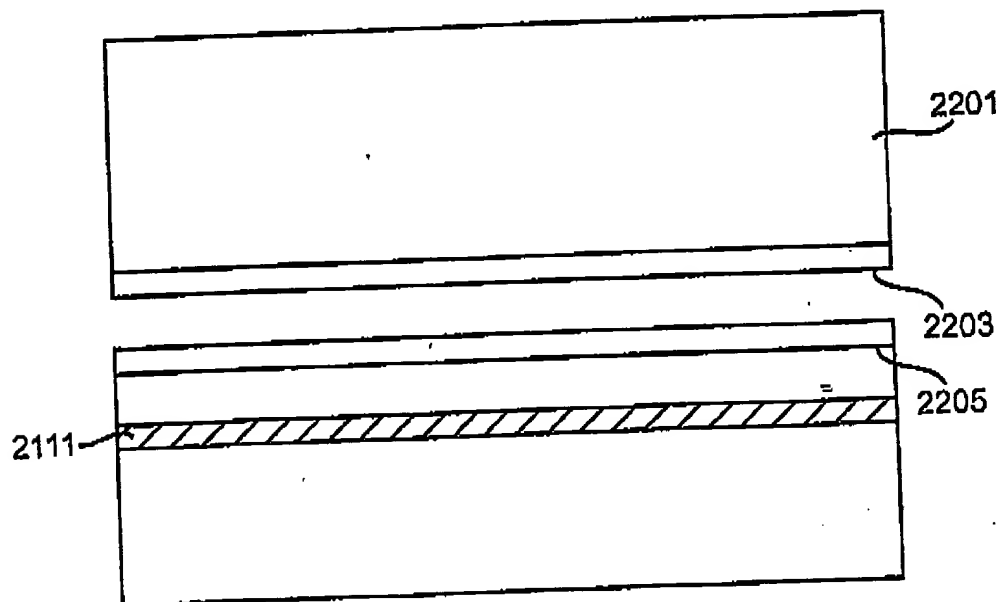


FIG. 2

JUL. 22. 2002

2:23PM

TOWNSEND & TOWNSEND

NO. 446

P. 14

Part of #8

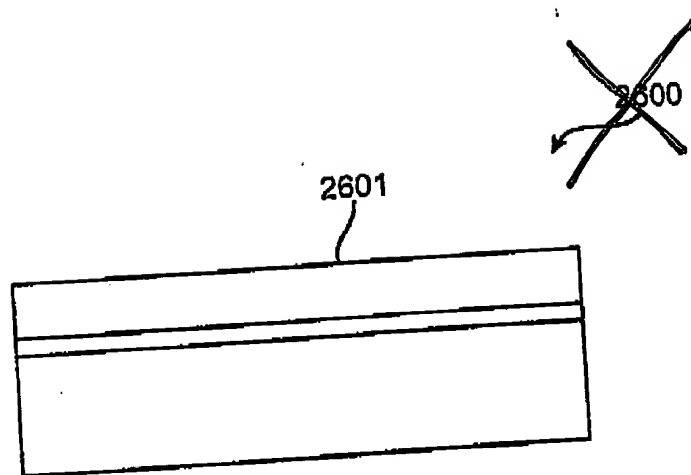


FIG. 5